



The January 28, 2011 Transit review of BERP V-I is based on implied dimensions from measurements taken of the graphics within the CAD files provided to CRC dated January 4, 2011.

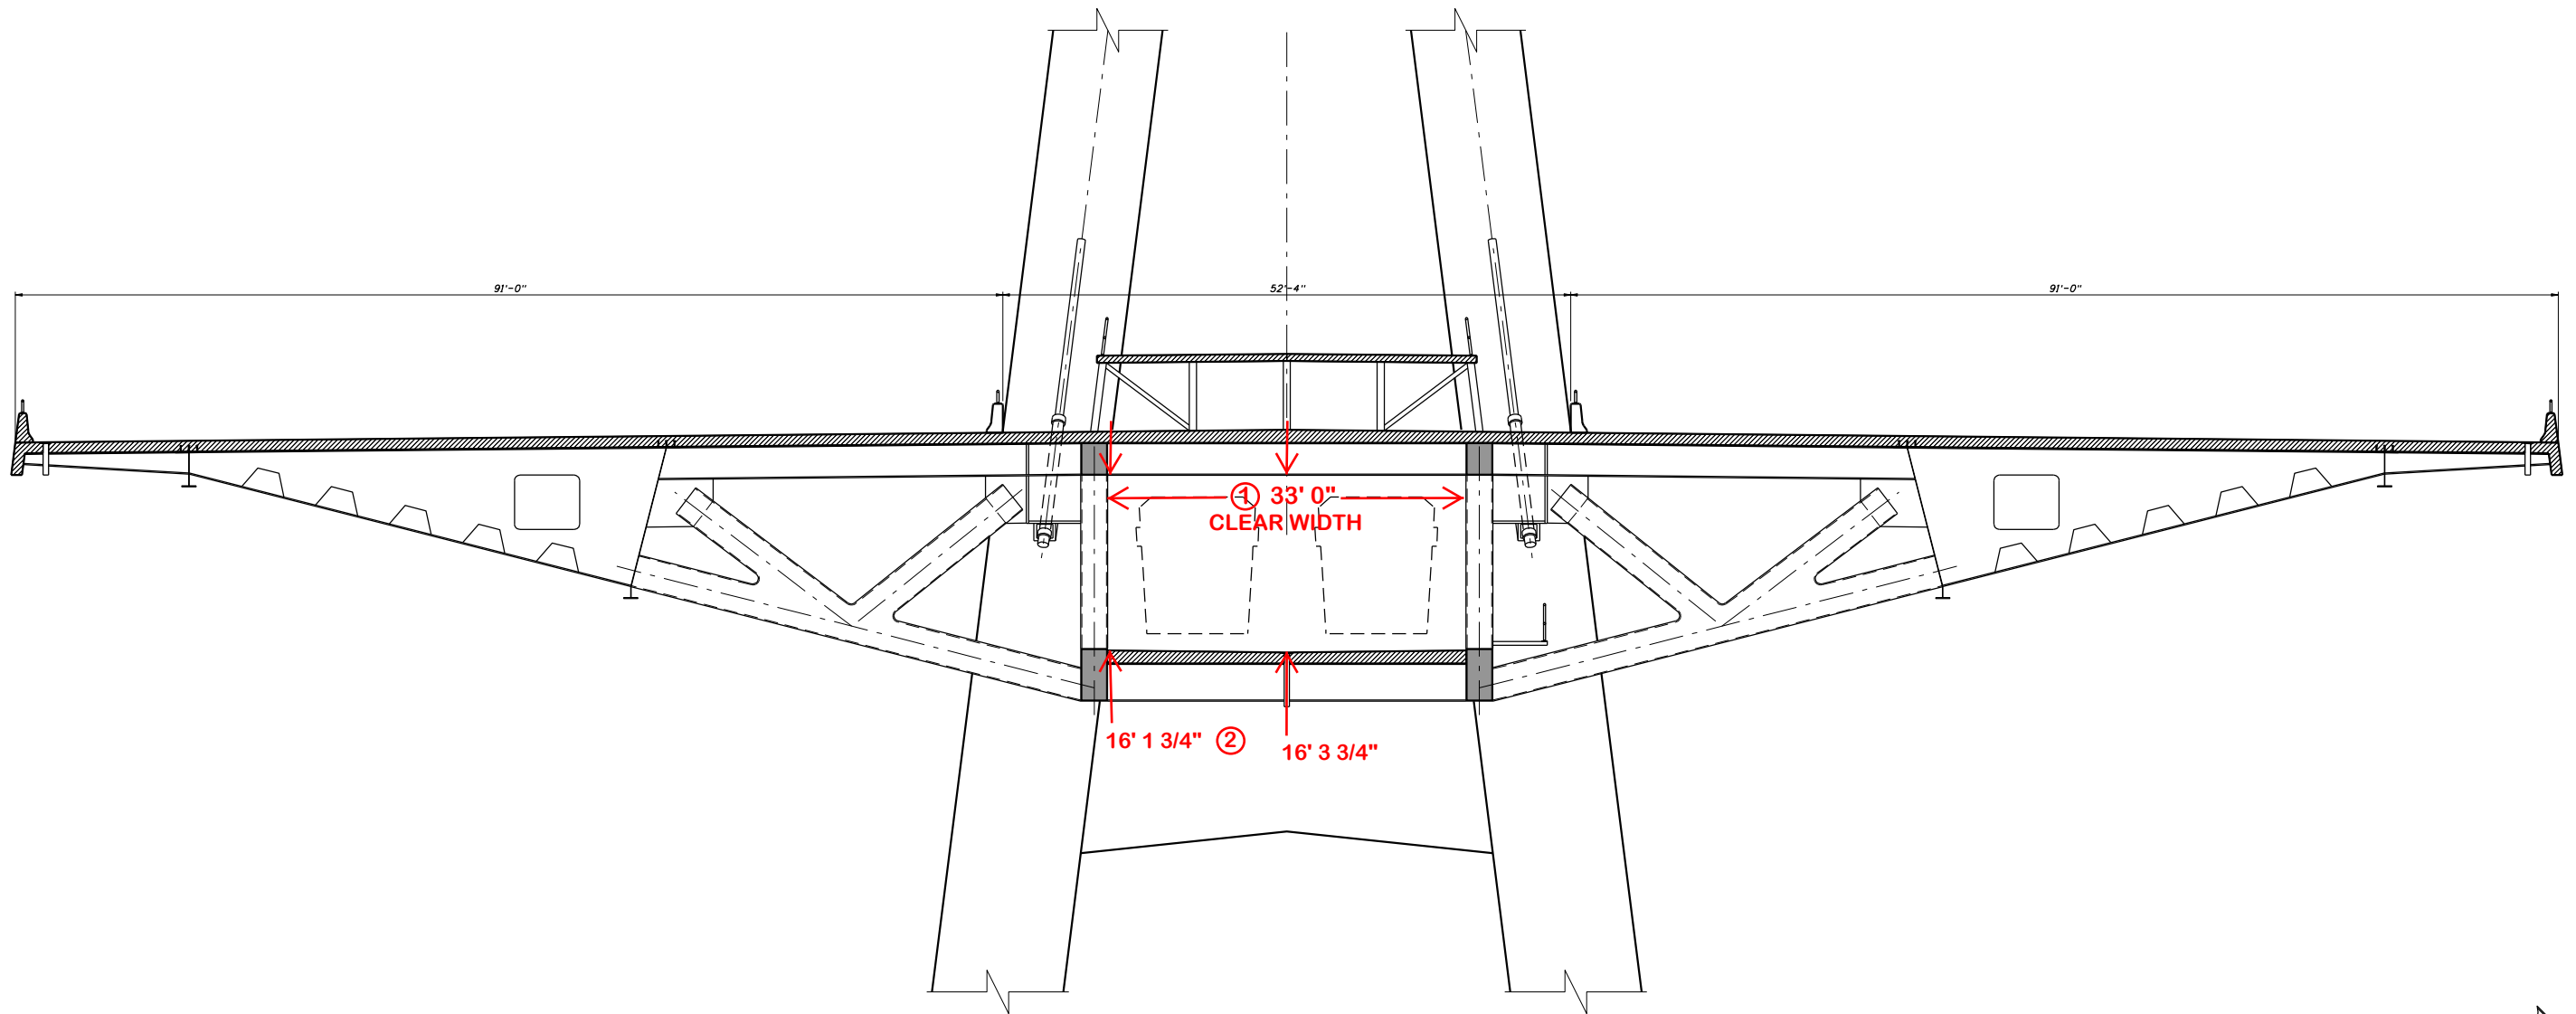

1. Apparent clear width of 33'-0" must be preserved. Any structural or non-structural bridge related appurtenances must exist outside the 33'-0" clear zone throughout the entire length of the river crossing.
2. Vertical clearance does not appear adequate. 16'-6" is the absolute minimum height acceptable for the combination of vertical clearance from top of rail to OCS wires (14'), OCS attachments (1'), rail and fasteners (1'-6").

DRAFT
DATE: 04.01.2011

Final Dimensions to be verified in Detail Design.																	
Project: COLUMBIA RIVER CROSSING																	
Title of Drawing: OPTION 1 CABLE STAY																	
<table border="1"> <tr><td>Date:</td><td></td></tr> <tr><td>Designed:</td><td></td></tr> <tr><td>Drawn:</td><td></td></tr> <tr><td>Approved:</td><td></td></tr> <tr><td>Scale:</td><td></td></tr> <tr><td>Job No.:</td><td></td></tr> <tr><td>Drawing No.:</td><td></td></tr> <tr><td>Index:</td><td></td></tr> </table>	Date:		Designed:		Drawn:		Approved:		Scale:		Job No.:		Drawing No.:		Index:		
Date:																	
Designed:																	
Drawn:																	
Approved:																	
Scale:																	
Job No.:																	
Drawing No.:																	
Index:																	